


PROPERTY CORNERS, SERVICE WALKS, CURB, OVERHEAD WIRES, NOT ENCRANCHING, AREA AND DESCRIPTION ARE OMITTED BY CONTRACTUAL AGREEMENT. BUYER MAY ORDER PROPERTY MARKERS AT A COST OF \$60 PER CORNER WITHIN 90 DAYS OF THE DATE OF THIS SURVEY. SURVEY INFORMATION AND/OR TOPOGRAPHY DEPICTED ON THIS SURVEY SHALL NOT BE REFERENCED TO OR USED FOR ANY OTHER DESIGN PURPOSES WITHOUT THE WRITTEN CONSENT OF STEVEN R. KELLY, P.L.S. I RESERVE THE RIGHT TO REVISE THIS SURVEY UPON THE RECEIPT OF AN UPDATED TITLE REPORT. IF BUILDINGS ARE ON THIS PLAN, BUILDING OFFSET DISTANCES SHOWN ARE FOR THE PURPOSE OF CHECKING COMPLIANCE WITH ZONING AND DEED RESTRICTIONS ONLY. NO LIABILITY WILL BE ACCEPTED IF THESE DISTANCES ARE USED FOR ANY OTHER PURPOSE. THIS SURVEY IS BASED ON SURVEY CONTROL FOUND AT THE TIME OF THE SURVEY. THIS SURVEY IS A RETRACEMENT OF A DEED DESCRIPTION PROVIDED BY OUR CLIENT AND DOES NOT DENOTE OWNERSHIP.

EQUESTRIAN (50' WIDE) LANE

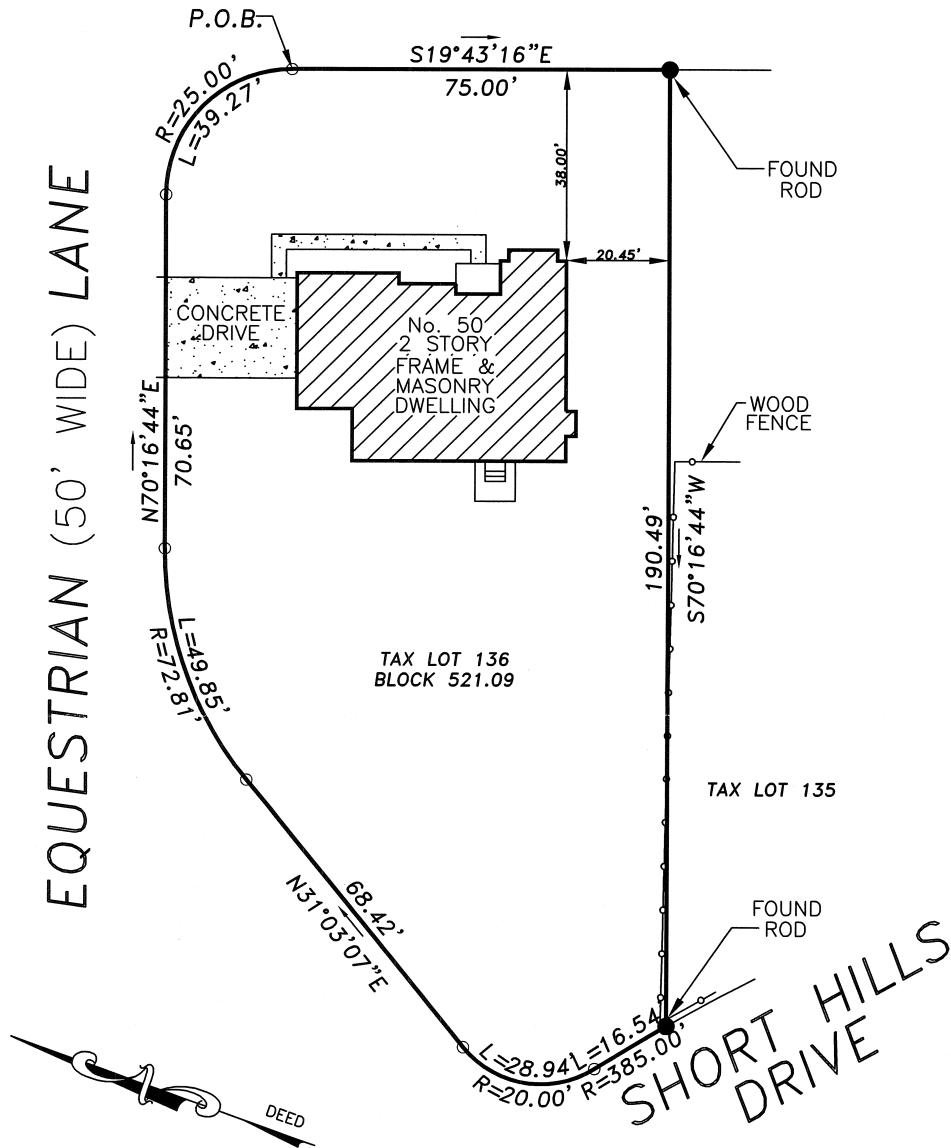

GROSS AREA = 17,226.13 S.F./0.40 ACRES

DESCRIPTION:
 BEING LOT 136, BLOCK 521.09, ON THE TOWNSHIP OF CHERRY HILL TAX MAP.
 BEING LOT 136, BLOCK 521.09, PLAN ENTITLED SHORT HILLS FARM, SECTION 4, FILED 10/28/96
 AS MAP #836-5.

THE UNDERSIGNED LICENSED SURVEYOR (L.S.) HEREBY DECLARES TO, AND SOLELY FOR THE BENEFIT OF,
 MOHAMMAD O. LARI & MAIMOONA O. LARI;
 CONGRESS TITLE DIVISION;
 CENTURY 21 MORTGAGE;
 ITS SUCCESSORS AND/OR ASSIGNS,
 AS THEIR INTEREST MAY APPEAR.

THAT THIS PLAN WAS PREPARED FROM A SURVEY MADE UPON THE PREMISES SHOWING, AS OF THE DATE OF THIS CERTIFICATE, THE LOCATION OF ALL BUILDINGS, EASEMENTS, OR SERVITUDES APPARENT FROM AN INSPECTION OF THE SURFACE OF THE PREMISES. THIS PLAN IS NOT TO BE REPRODUCED IN ANY MANNER, NOR MAY IT BE RELIED UPON BY ANYONE OTHER THAN THE ABOVE NAMED PERSON OR PERSONS FOR WHOSE BENEFIT IT HAS BEEN PREPARED AND EMBOSSED WITH AN IMPRESSION SEAL. COPIES OF THIS PLAN WITHOUT IMPRESSION SEAL AND SIGNATURE IN RED INK ARE FOR MERE CONVENIENCE OF REFERENCE ONLY.

5/13/05

LICENSED LAND SURVEYOR No. 22714

STEVEN R. KELLY, P.L.S.

COPYRIGHT © 1993, 1994 & 1995 by STEVEN R. KELLY, P.L.S. ALL RIGHTS RESERVED

NOTES: 1. NOT TO BE USED FOR CONSTRUCTION.
 2. NOT TO BE USED WITH A SURVEY AFFIDAVIT.

RESURVEYED 5/12/05



STEVEN R. KELLY, PROFESSIONAL LAND SURVEYOR
 P.O. BOX 51, HADDONFIELD, N.J. 08033
 PHONE (800) 433-0384

MAP SHOWING SURVEY SITUATE IN
 TOWNSHIP OF CHERRY HILL
 COUNTY OF CAMDEN, N.J.
 No. 50 EQUESTRIAN LANE

DATE 12/17/04	SCALE 1"=30'	DRAWN CK	CHKD SK	JOB No. 20041170
------------------	-----------------	-------------	------------	---------------------